

NORTH

1 ELECTRICAL SITE PLAN

SCALE = 1" = 30'-0"

## SYMBOL SCHEDULE

FIELD SPORTS LIGHTING POLE & FIXTURES — — — — UNDERGROUND ELECTRICAL SERVICE

□ PULLBOX

EXIST. LIGHT POLE

## ELECTRICAL SITE PLAN NOTES

- 1. FINAL POLE LOCATIONS SHALL BE SHIFTED AS APPROVED BY ENGINEER TO AVOID CONFLICTS REPAIRING GROUND AND CONCRETE WALK WITH HIDDEN OBSTRUCTIONS TO ACHIEVE REQUIRED FOOT CANDLE LEVELS WITH APPROPRIATE MAXIMUM/MINIMUM REQUIREMENTS.
- 2. CONTRACTOR SHALL FURNISH PHOTOMETRIC PRINTOUT OF FIELD INDICATING POLE LOCATIONS, QUANTITY OF FIXTURES, FIXTURE AIMING POSITIONS, AND MAXIMUM/MINIMUM VALUES PRIOR TO BIDDING.
- INSTALLATION OF POLES WILL NOT BE ALLOWED UNTIL CONTRACTOR RECEIVES APPROVAL OF PHOTOMETRIC PRINTOUT.
- 4. EXISTING ELECTRICAL DEVICES AND ASSOCIATED CIRCUITS TO REMAIN AND SHALL BE SUPPORTED DURING CONSTRUCTION, UNLESS NOTED OTHERWISE. PROVIDE TEMPORARY POWER CONNECTIONS TO EXISTING CIRCUITS.
- 5. INSTALLATION OF POLES WILL NOT BE
  ALLOWED UNTIL LOUISIANA CIVIL ENGINEER
  PREPARED FOUNDATION DRAWINGS HAVE BEEN ELECTRICAL SITE PLAN KEYNOTES APPROVED.
- 6. IF CONTRACTOR MUST BE REQUIRED TO REMOVE ANY EXISTING FENCING TO OBTAIN EQUIPMENT ACCESS TO WORK AREAS, THE FENCING SHALL BE REPLACED AT COMPLETION OF PROJECT. CONTRACTOR SHALL MAINTAIN SITE SECURITY WHILE FENCING IS REMOVED.

- WAYS/DRIVES WHERE DAMAGED DURING CONSTRUCTION. CONTRACTOR SHALL NOT CROSS BASEBALL FIELD WITH CONSTRUCTION
- 8. DEMOLITION EXISTING ELECTRICAL LIGHTING EQUIPMENT (VERIFY WITH ENGINEER PRIOR TO DEMOLITION) 9. CONTRACTOR SHALL TURN OVER ALL
- 10. REUSE EXISTING CONDUIT WHERE POSSIBLE. ANY BROKEN OR MISSING UNDERGROUND CONDUIT SHALL BE NOTED AND BROUGHT TO THE ATTENTION OF THE ENGINEER IMMEDIATELY.


DEMOLISHED ITEMS TO OWNER FOR DISPOSAL.

11. COORDINATE THE REINSTALLATION LOCATION OF EXISTING SPEAKERS WITH OWNER. CONTRACTOR SHALL TEST AND VERIFY SOUND AFTER REINSTALLATION.

(1) NEW GALVANIZED STEEL RACK. SEE RISER DIAGRAM FOR MORE DETAIL.



I drawings and written material appearing herein constitu original and unpublished work of the engineer and may not be duplicated, used, or disclosed without written consent o responsible for verifying any and all quantities included in these documents when bidding and during construction.

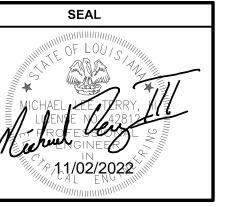

PROJECT INFORMATION REGIRA FIE LIGHTING

	REVISIONS						
1	ADDENDUM 1	11/02/22					

Г	SHEET INFO	ORMATION
D	ATE:	09/08/2022
D	RAWN BY:	CC
С	HECKED BY:	SC
Р	ROJECT #:	22-092

SHEET NAME

**ELECTRICAL SITE PLAN** 

SHEET NUMBER

E2.0



MAX. OF SIX (6) FIXTURES PER CROSS ARM (TYPICAL) - AREA SPORTSLIGHT FIXTURE; SEE FIXTURE SCHEDULE THIS SHEET; VERIFY MOUNTING CONFIGURATION PRIOR TO PURCHASE SEGMENTED STEEL DIRECT BURIAL POLE -NEMA 3R ENCLOSURE W/ DISCONNECT SWITCH & FIXTURE CIRCUIT TERMINAL PANEL ON EACH POLE; PROVIDE A SURGE PROTECTION DEVICE AT EACH TERMINAL PANEL (PROVIDE TWO (2) AT EACH POLE LIGHTING TWO FIELDS) PULL BOX FLUSH WITH GRADE-∏+-HAND HOLE GRASSY AREA-/ 1/2" TANK GROUND TO #2/0 AWG STRANDED CU WIRE CONTRACTOR SHALL COVER
OPENINGS ON EACH POLE TO
PREVENT ENTRANCE OF WATER, MUD, ETC. INTO POLE-→ GROUND ROD CONDUITS FOR PANEL FEEDER, AND LIGHT FIXTURES ROUTED UP INTO THIS FOUNDATION DETAIL ILLUSTRATES A TYPICAL FOUNDATION AND IS TO BE USED FOR ILLUSTRATION PURPOSES ONLY. THE FOUNDATION SHALL BE DESIGNED BY A LOUISIANA REGISTERED PROFESSIONAL CIVIL ENGINEER PER ELECTRICAL POLE; POWER SUPPLIED BY OWNER -BACKFILL MATERIAL: -2500 PSI (MIN.) CONCRETE -CRUSHED AGGREGATE MATERIAL COMPACTED TO 95% SPD IN 8" SPECIFICATIONS. CRUSHED AGGREGATE OR CONCRETE SETTING PAD

FIXTURE SCHEDULE

- ANTI-ROTATION BEARING PLATE

<u>EGRESS</u>
GeoSport Elite Clir 630W Light Loss Factor = 0.950 Watts per luminaire = 632


<u>EW60</u> GeoSport Elite Clir EV 630W Light Loss Factor = 0.950 Watts per luminaire = 612

W40 GeoSport Elite Clir EV 630W Light Loss Factor = 0.950 Watts per luminaire = 631

M20 GeoSport Elite Clir EV 630W Light Loss Factor = 0.950 Watts per

N15 GeoSport Elite Clir EV 630W Light Loss Factor = 0.950 Watts per luminaire = 610

NOTE: ALL FIXTURES SHALL BE SENT WITH PHOTOMETRIC REPORTS AND LAYOUTS FOR PRIOR APPROVAL.

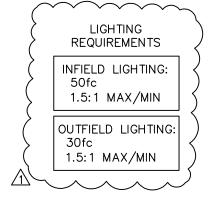

→ DETAIL - TYPICAL POLE DETAIL

SCALE = N.T.S


		PC	)LE		SC	HE	-Dl	JLE	<u>-</u> -		
Pole	X	у	height	N15	M20	W40	EW60	EGRESS	М	Total	kW
A1	-40	30	60FT	1	2	3				6	3.7
A2	50	-45	60FT		6	1	3			5-5	6.2
А3	99	-83	60FT		4	3	3			5-5	6.2
B1	-10	205	60FT	3	6	1	1			11	6.8
B2	195	-24	60FT	3	8	4	1			11-5	9.9
В3	352	-38	60FT	3	6		1			10	6.2
B4	<del>\</del> 132\	~258	<b>√60F</b> ₹	3~	6~		2~		$\langle$	10~	6.2
B5_	76	-259	60FT	2	6	<u> </u>	2			10	6.2
	<u>-129.8</u>	-64.5	60FT	$\frac{1}{2}$	5		$\frac{1}{2}$			\ <u>\</u>	5.5
OTHER								8		8	5.0
$+\!$	~~~	$\sim$	<b>\</b>	~		<b>\</b>	$\sim$			<b>\</b>	$\overline{}$
Total				17	49	12	14	8		100	62
NOTE 1.	S: POLES A1		—		— — —			ss			

FIXTURE EACH AT 40' ABG. POLES A2, A3, AND B2 HAVE TWO FIELD AIMED EGRESS FIXTURES EACH AT 40' ABG.
COORDINATE EGRESS LIGHTING PLACEMENT AND
AMING WITH THE ENGINEER PRIOR TO CONSTRUCTION.

POLE B5 SHALL HAVE ONE M20 AIMED TOWARDS BULLPEN CONTROLLED BY AN INDEPENDENT

7600 Innovation Park Drive Baton Rouge, LA 70820

All drawings and written material appearing herein constitu original and unpublished work of the engineer and may no be duplicated, used, or disclosed without written consent o the engineer. Do not scale drawings. Contractor is responsible for verifying any and all quantities included in these documents when bidding and during construction.

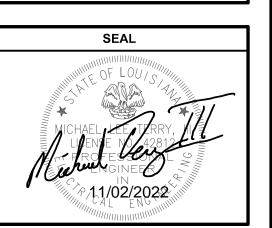

PROJECT INFORMATION REGIRA FIE LIGHTING


	REVISIONS	
1	ADDENDUM 1	11/02/22

١.		
	SHEET INF	ORMATION
	DATE:	09/08/2022
	DRAWN BY:	CC
	CHECKED BY:	SC
	PROJECT #:	22-092

**SHEET NAME** LIGHTING PLAN & DETAILS

SHEET NUMBER

E3.0

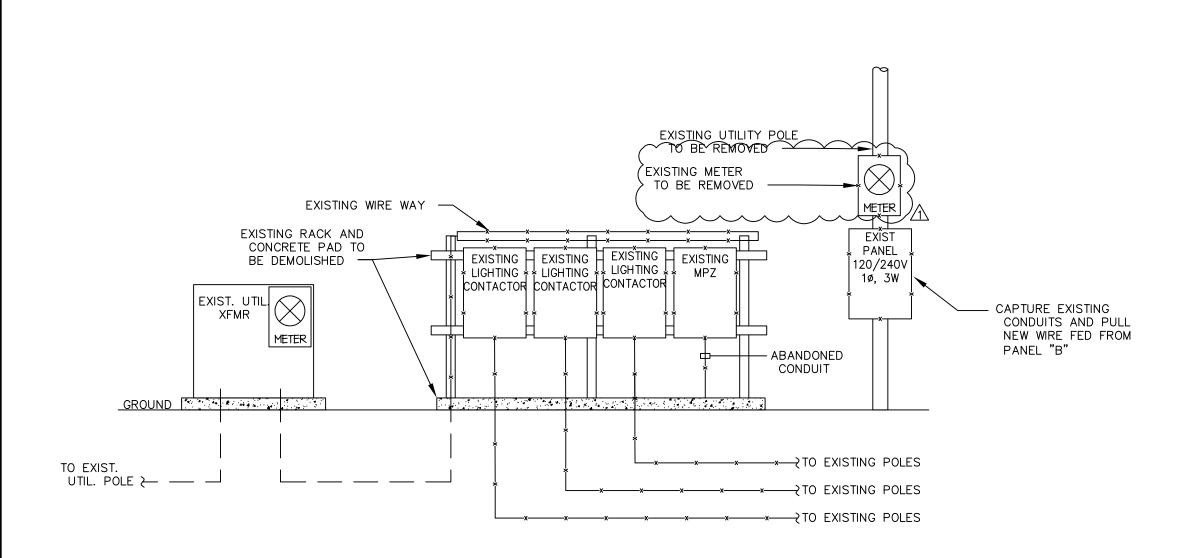

1 DEMOLITION RISER DIAGRAM SCALE = N.T.S

TYPE:BOLT-ON BREAKER PANELBOARD


MAIN:200 AMP MCB

MOUNTING:SURFACE

SERVICE:277/480 VOLT, 3ø, 4W

*AIC*:22,000 REMARKS:GROUND BUS NEMA 3R

pos.	bkr.	trip	bkr.	wire size				L	OAD V.	. <b>A</b> .	pos.	bkr.	trip	bkr.	wire		service
no.	no.	amp	pole	size	cd	service		Αø	Βø	Сø	no.	no.	amp	pole	size	cd	service
1	1	40	3	6	1"	CONTACTOR	"F1"	6930 6300	<b>\</b>		2	2	35	3	8	3/4'	CONTACTOR "F2"
3						"		]	6930 6300	<b>\</b>	4						"
5						"			·	6930 6300	6						"
7	3	35	3	8	3/4'	CONTACTOR	"F3"	5880 12500	<b>\</b>		8	8	70	2	8	1"	25 KVA XFMR "T1"
9						"		]	5880 12500	<b>\</b>	10						"
11						"			·	5880	12						SPACE
13						SPACE	<b>(</b>	<u>-</u>	<b>\</b>		14	14	30	3	10	3/4'	SPD
15						"		]	<del> -</del>  -	<b>\</b>	16						"
17						22			·	<del> -</del>	18						n
		•			co	nnected V.A.	per phase	31,610	31,610	19,110							
						total amps	per phase	114.2	114.2	70.0							

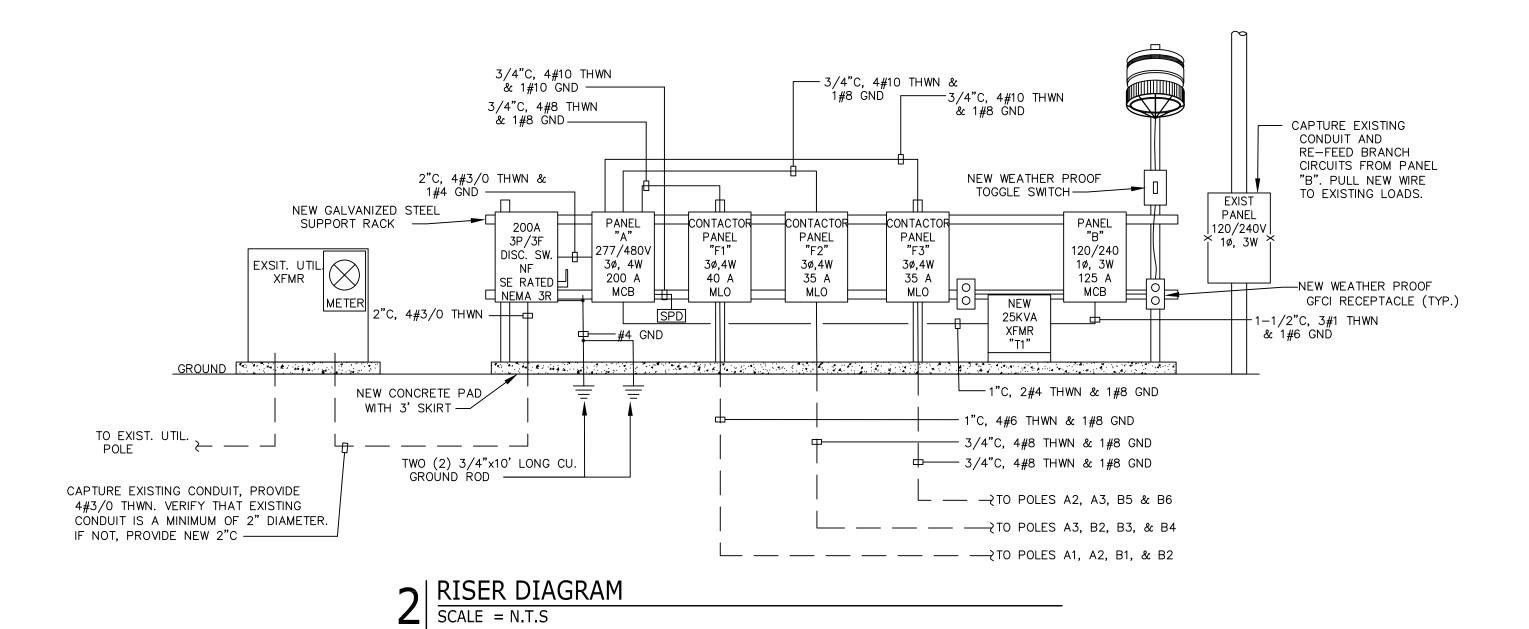


TYPE:BOLT-ON BREAKER PANELBOARD SERVICE:120/240 VOLT, 1ø, 3W

MAIN:125 AMP MCB

*AIC*:10,000 REMARKS:GROUND BUS NEMA 3R

MOUNTING:SURFACE

pos.	bkr.	trip	bkr.	wire			LOAD	V. A.	pos.	bkr.	trip	bkr.	wire		service
no.	no.	amp	pole	size	cd	service	Αø	Βø	no.	no.	amp	pole	size	cd	service
1	1	20	1			EXIST. BREAKER	1920 1920	>	2	2	20	1	12	3/4'	EXIST. BREAKER
3	3	20	1			EXIST. BREAKER	1	1920 1920	4	4	20	1		•	EXIST. BREAKER
5	5	20	1			EXIST. BREAKER	1920 1920	>	6	6	20	1			EXIST. BREAKER
7	7	20	1	12	3/4"	EXIST. BREAKER	1	1920 1920	8	8	20	1	12	3/4'	EXIST. BREAKER
9	9	20	1	12	3/4"	EXIST. BREAKER	1920 -	>	10	10					SPACE
11	11					SPACE	1		12	12					n
13	13					"	_	>	14	14					"
15	15					"	1		16	16					"
17	17					"	_	>	18	18					n
					co	nnected V.A. per phase	9,600	7,680							•
						total amps per phase	80	64	<u></u>						

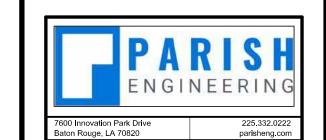

II drawings and written material appearing herein constitut original and unpublished work of the engineer and may not be duplicated, used, or disclosed without written consent of the engineer. Do not scale drawings. Contractor is responsible for verifying any and all quantities included in these documents when bidding and during construction.



ELD. REGIRA FIE LIGHTING

PROJECT INFORMATION

REVISIONS								
1	ADDENDUM 1	11/02/22						

SHEET INFORMATION							
DATE:	09/08/2022						
DRAWN BY:	CC						
CHECKED BY:	SC						
PROJECT #:	22-092						

SHEET NAME ELECTRICAL RISER DIAGRAM & PANEL SCHEDULES

SHEET NUMBER

E4.0

